


LEGEND:
EP ELECTRICAL PANEL
T TRANSFORMER



ORIENTATION



AERIAL VIEW


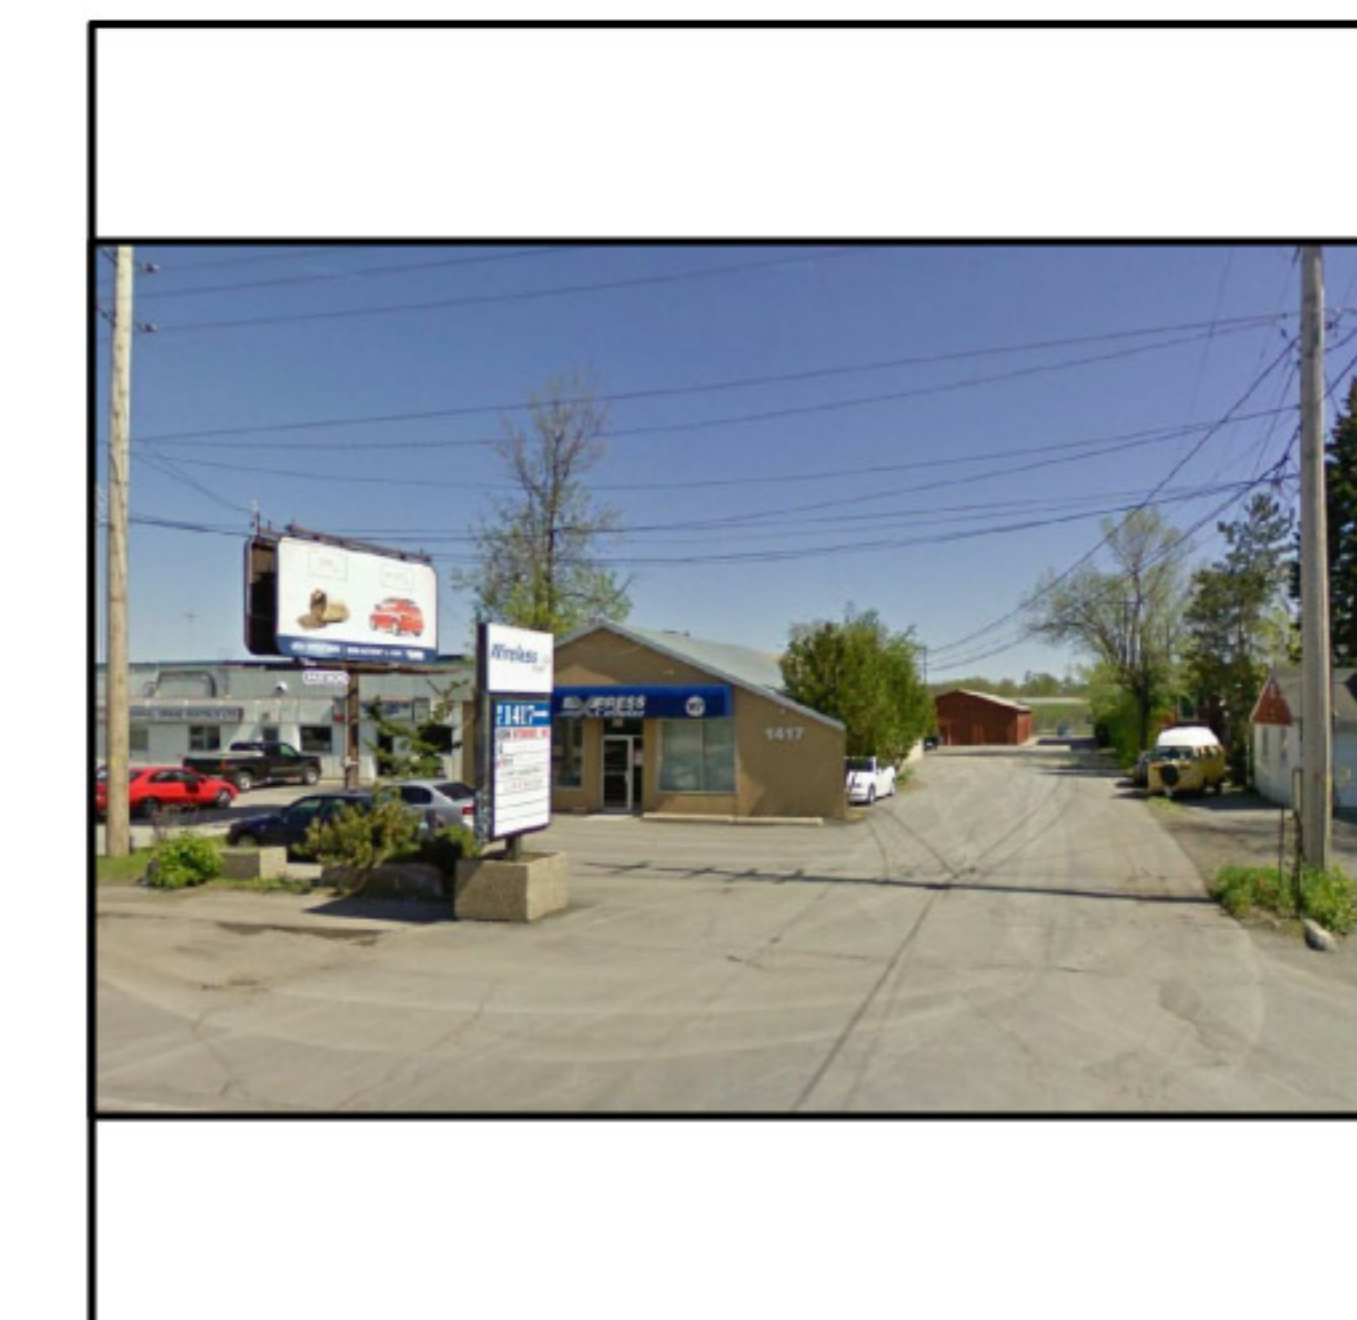


CYRVILLE RD. VIEW



HWY 417 VIEW

PREPARED FOR: District Realty Corporation,
Brokerage
ADDRESS: 1417-C Cyrville Rd.,
Ottawa, ON
DATE: October 15, 2010
REVISION: n/a
PROJECT NUMBER: 100084
DRAWING SIZE: 8.5" x 14" - Legal Size

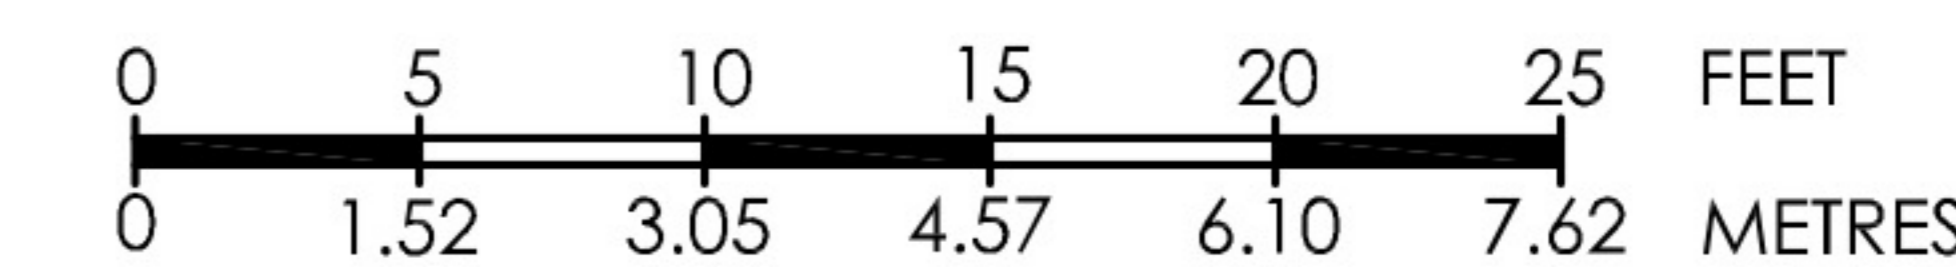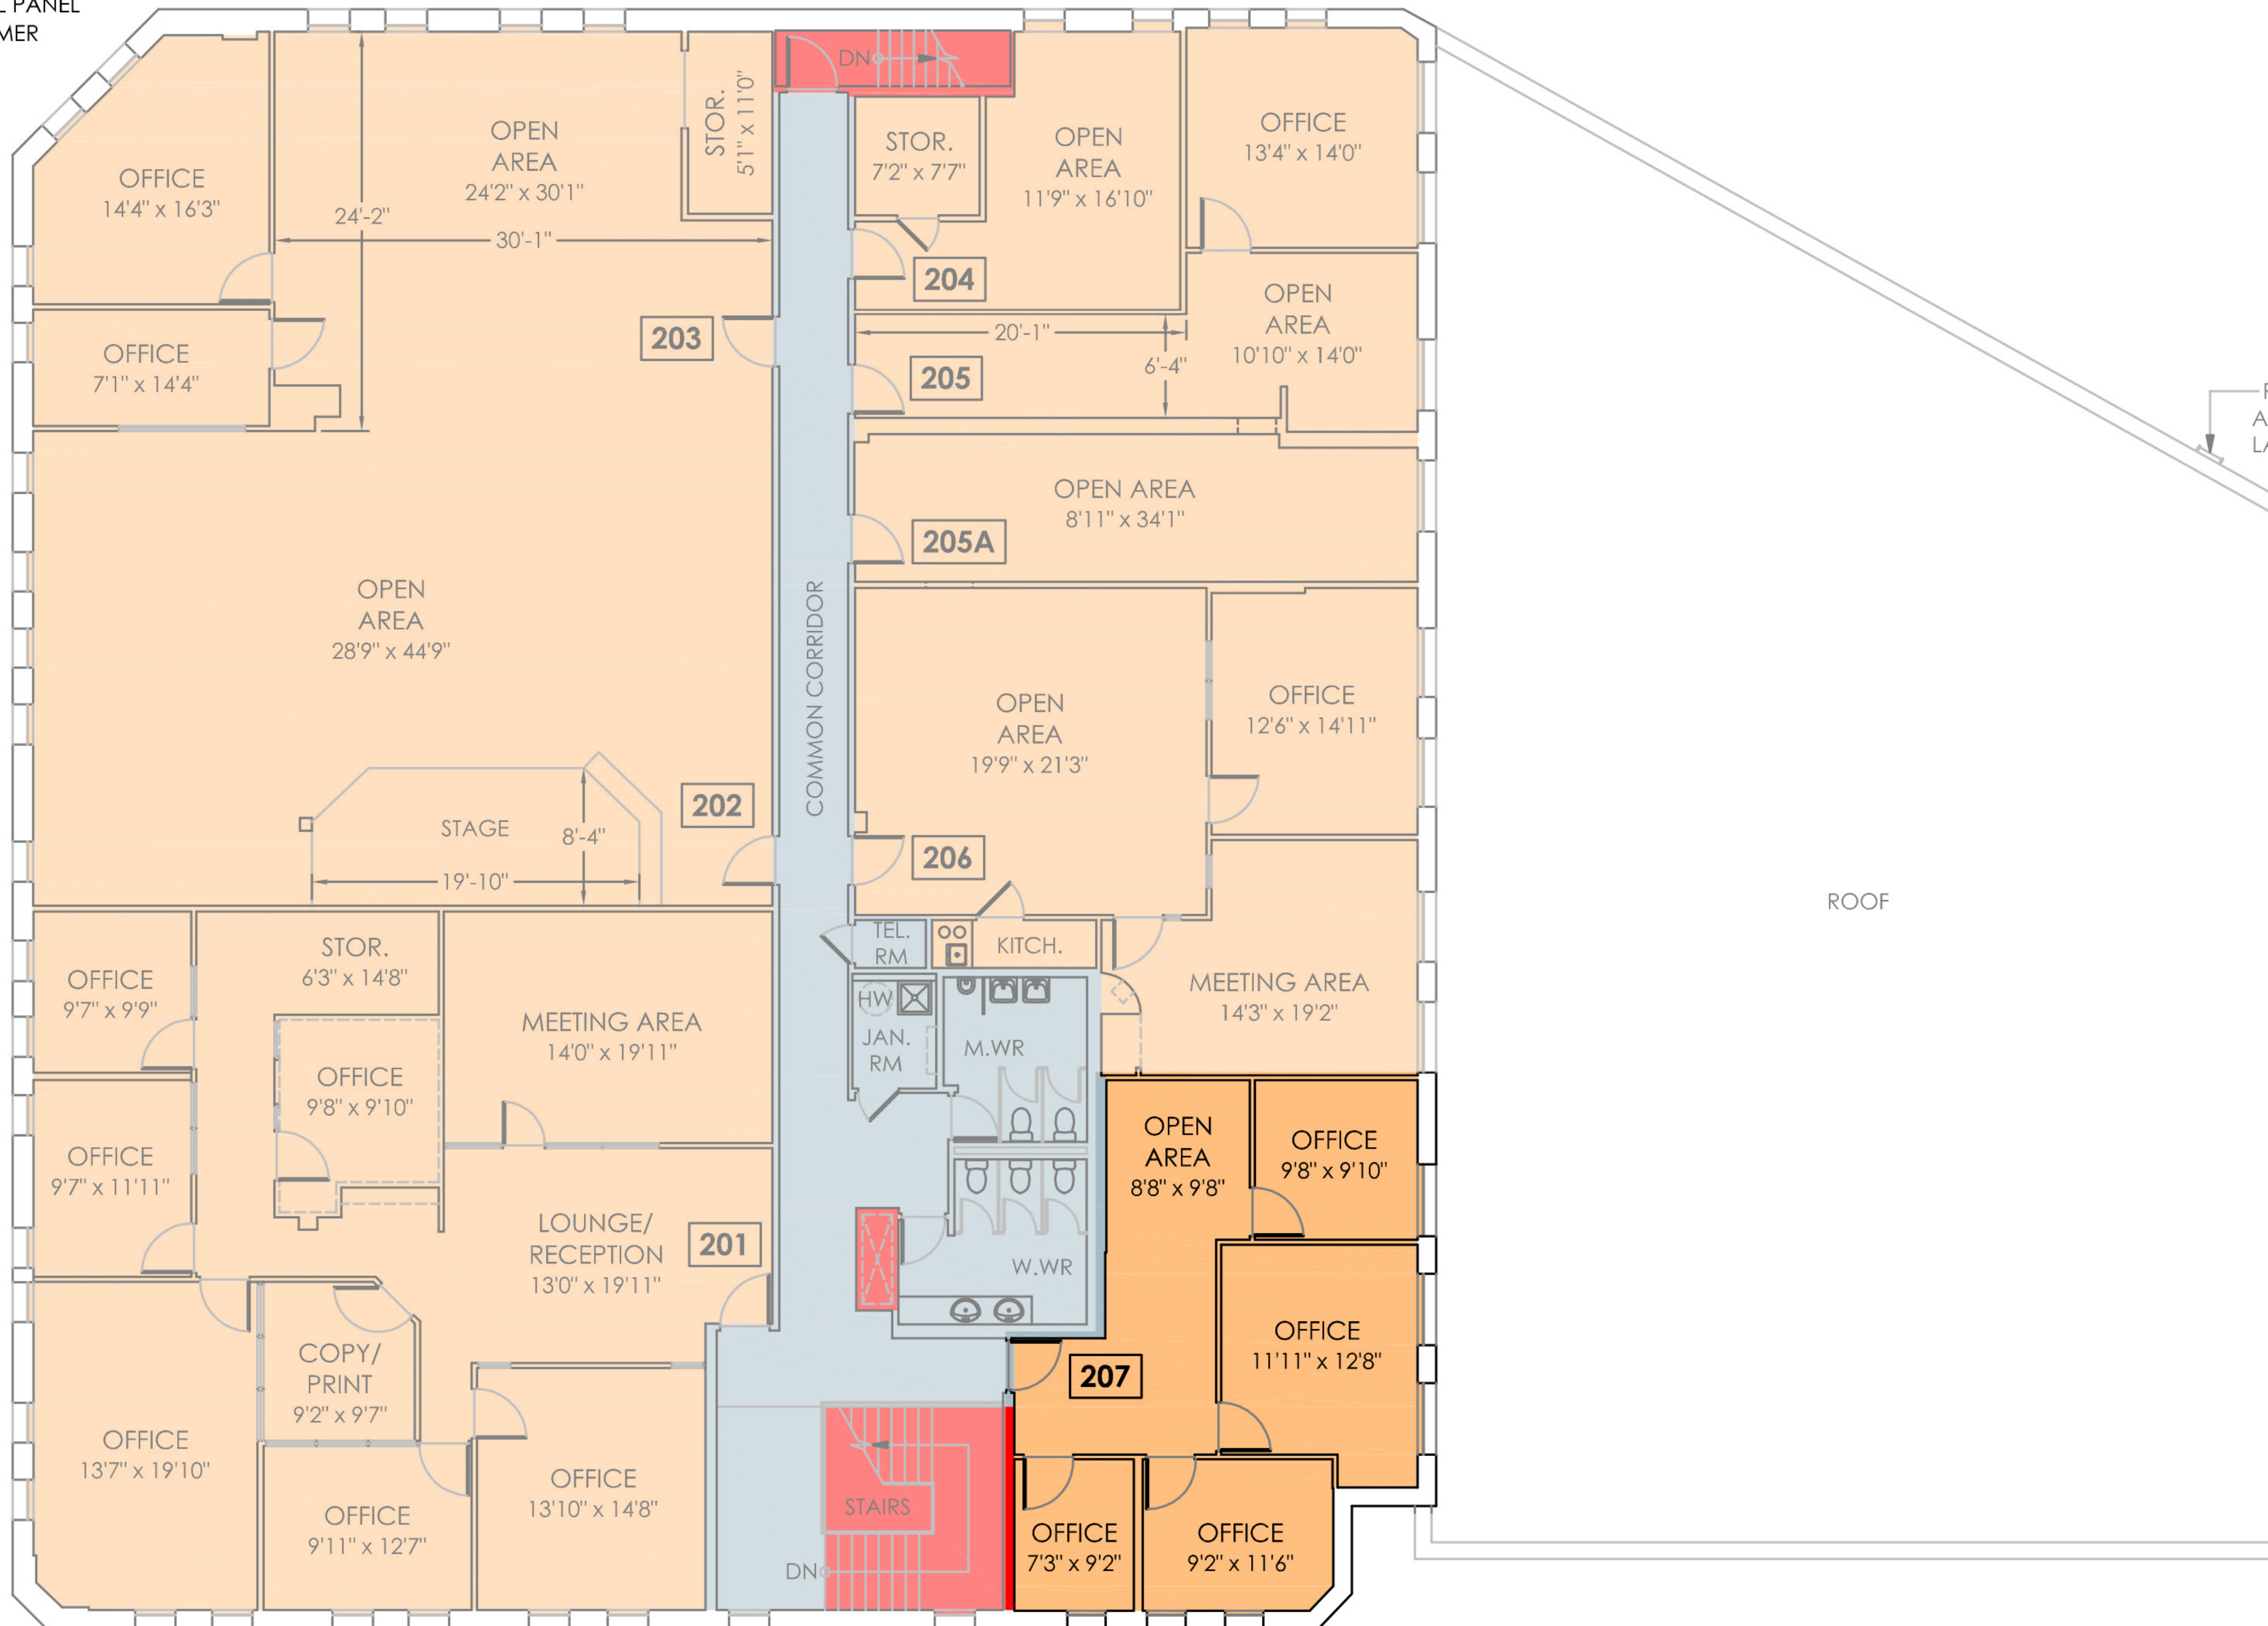

PREPARED BY: ECHOFLOORPLANS.COM

ECHO FLOOR PLANS
As-Built Floor Plans
Area Analysis
Space Planning
www.ECHOFloorPlans.com